


TV AND VERANDAH LOUNGE BENCH X 4

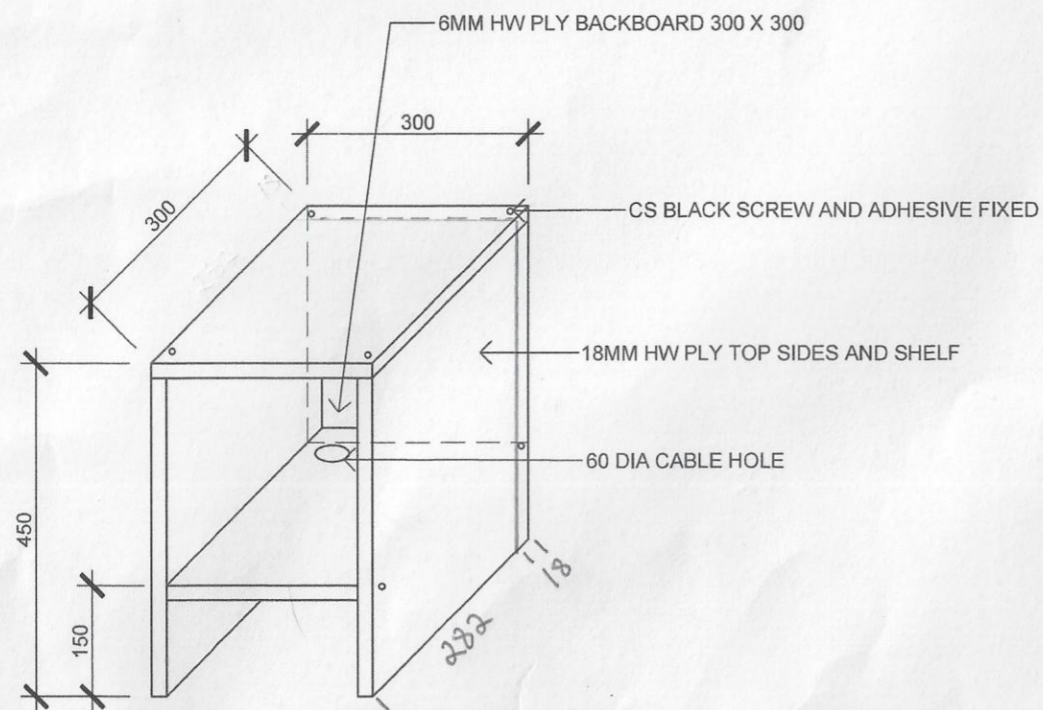

BEDSIDE TABLE X 18
14-11-25

ISOMETRIC VIEWS 1:10
Gaboon Marine Plywood
 ALL IN ~~HARDWOOD PLY TUNG~~
~~OIL SEALED~~
 18mm 2440 x 1220
 Poly clear Lacquer

Cabinet Decor

A.D.O ARCHITECTS DESIGN OFFICE 54 GLASSHOUSE ROAD COLLINGWOOD VIC 3066 T 0411416848 E AIDANHALLORAN.ADO@GMAIL.COM	NOTES DIMENSIONS ARE TO STRUCTURE UNLESS OTHERWISE NOTED THE CONTRACTOR SHALL VERIFY ALL QUANTITIES, DIMENSIONS & LEVELS ON SITE PRIOR TO COMMENCEMENT OF WORK OR PREPARATION OF SHOP DRAWINGS. ALL MATERIALS & WORKMANSHIP SHALL CONFORM TO THE AUSTRALIAN STANDARDS, THE NCC AND LOCAL COUNCIL REQUIREMENTS. ITN ARCHITECTS INTERNATIONAL PTY LTD RETAINS ALL MORAL & COPY RIGHTS.	PROJECT TEAM CLIENT	REVISION SCHEDULE NO. DESCRIPTION DATE	PROJECT CONTINENTAL HOUSE 9 LONE PINE GROVE HEPBURN SPRINGS	ISSUE 3-10-25 PHASE CONCEPT SCALE 1:10 @ A3 DIR AH BY: AH REV	PLY FURNITURE DETAILS